

STATE OF CALIFORNIA - DEPARTMENT OF TRANSPORTATION

DESIGN OVERSIGHT

BEHZAD GOLEMOHAMMADI

CALCULATED/DESIGNED BY

CHECKED BY


DATE 01/0

SYC

FW

REVISED BY

DATE REVISED

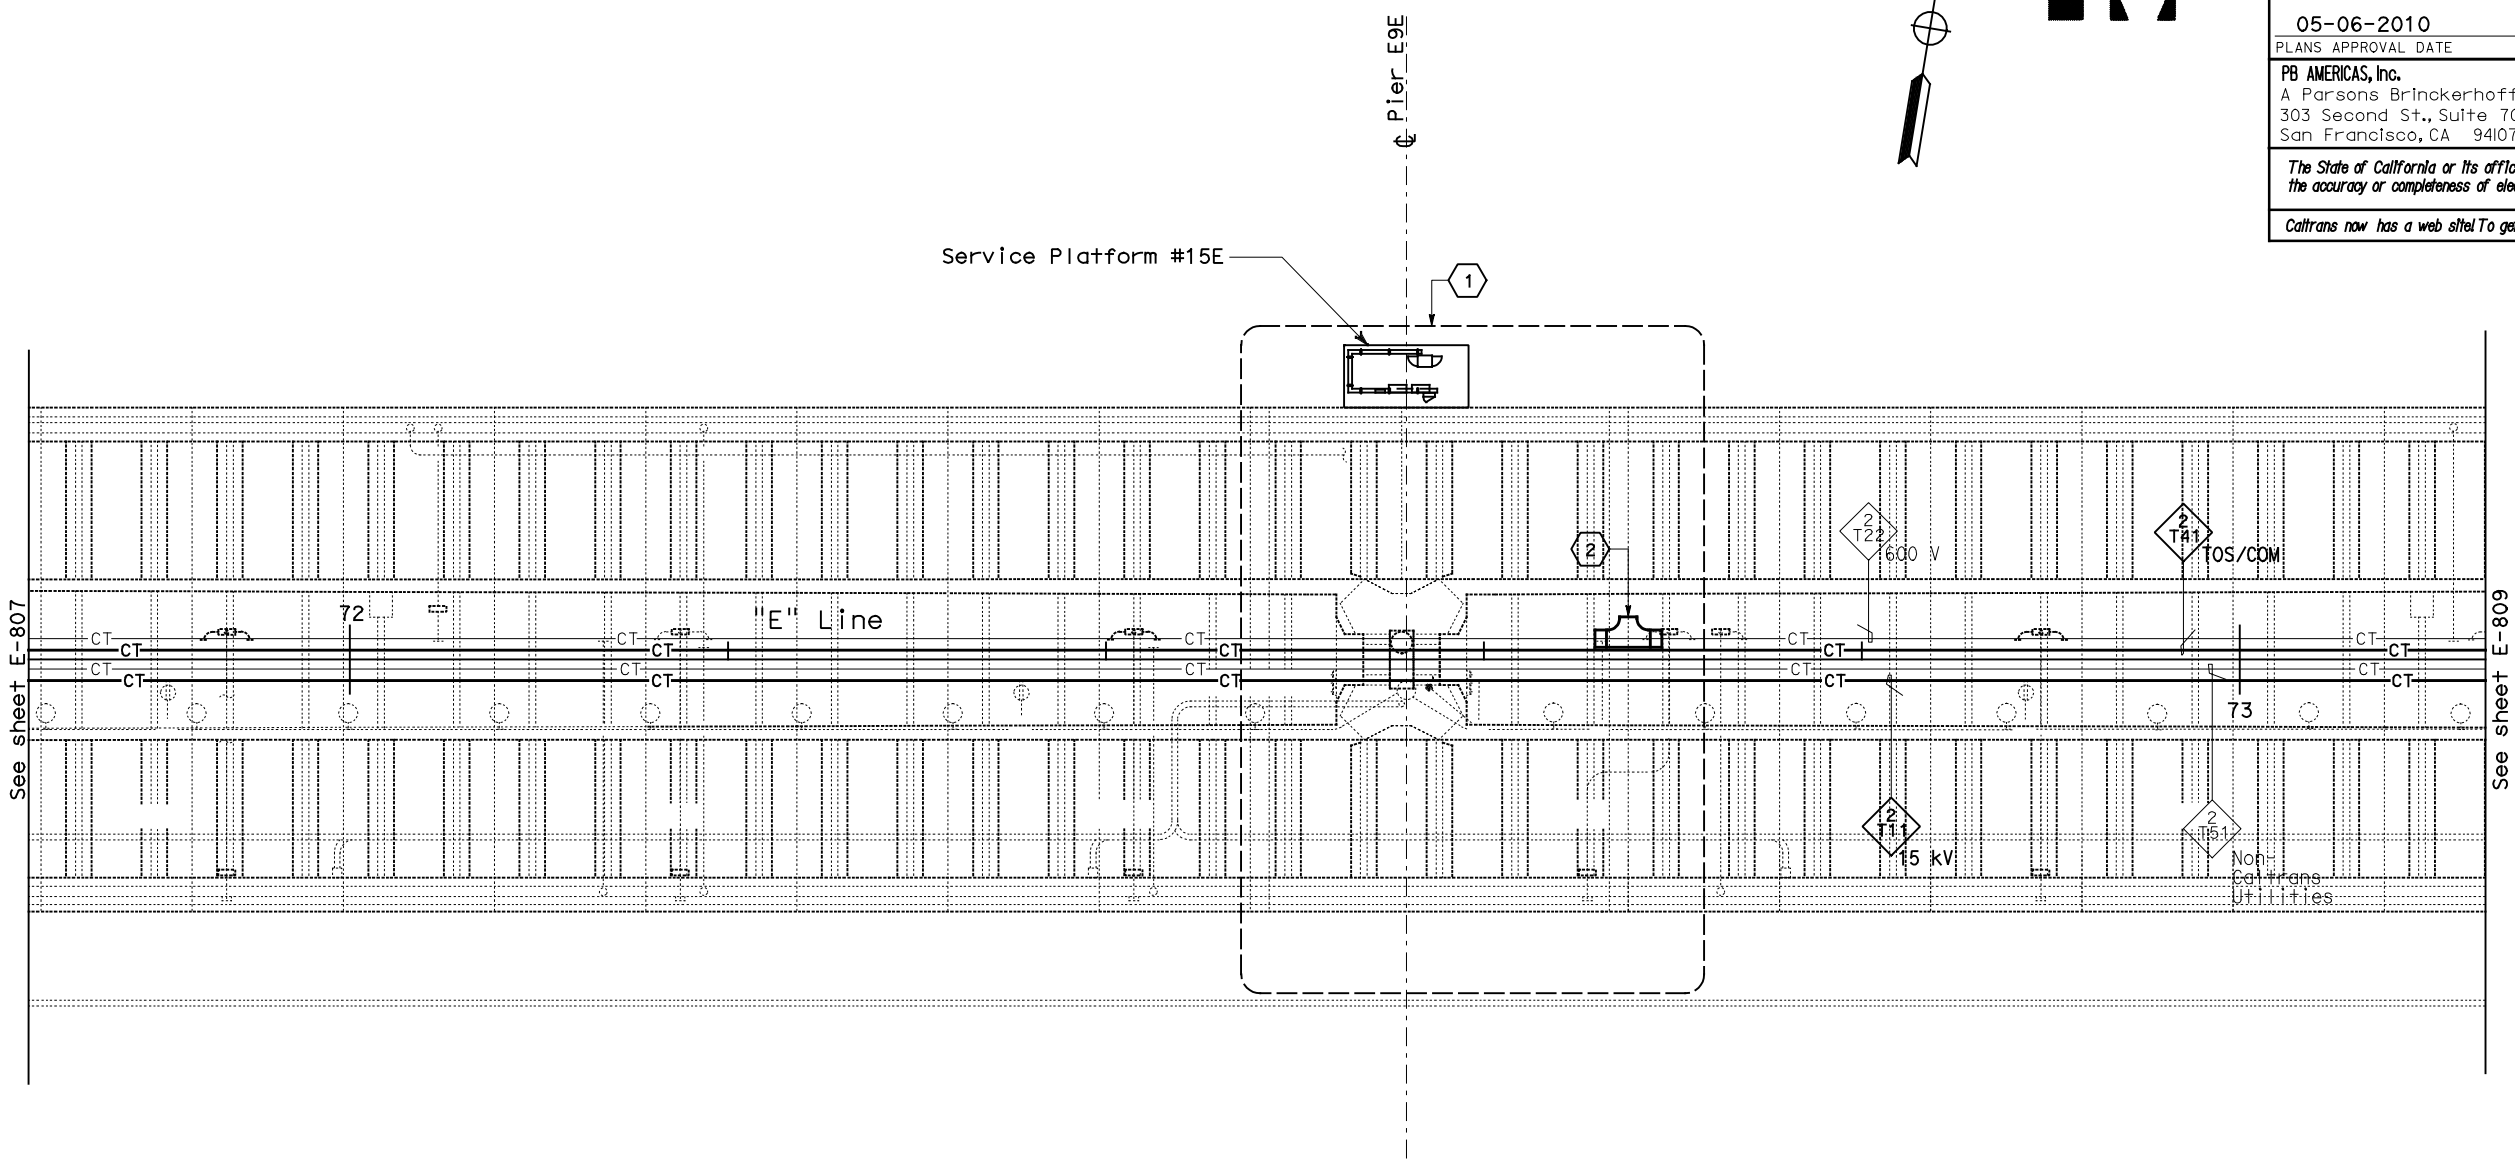

CONDUIT AND CABLE TRAY PLAN

NOTES:

- This plan sheet is a record drawing from Skyway Structures contract. The Contractor shall verify the existing installation. See sheet EE-89 of Skyway Structures Contract No. 04-012024.
- The installed components shall not be limited to the ones listed below, but shall be a complete installation. For details, see Bridge Structures Girder Eastbound, typical Details sheets.
 - Furnish and install 15 kV cables into existing cable tray shown on this drawing. Refer to riser diagram on E-837.
 - Furnish and install TOS fiber optic cables into existing cable tray shown on this drawing. Refer to riser diagram on E-983.
 - Inspect for system ground continuity. See sheets E-839 and E-840.
- All cable trays shown on this drawing are existing. Bold ones are to be used for pulling cable.

SHEET NOTES:

- For Service Platform #15E details, see sheet E-828.
- Furnish and install splice cable tray as shown on sheet E-836, plan detail 2.

REQUEST FOR INFORMATION NOT ADDRESSED IN THIS CCO REMAIN IN FORCE					
	03/08/10	MEP INTEGRATION	SYC	FW	110
MARK	DATE	DESCRIPTIONS	BY	CH'D	CCO#
REVISIONS					


CONTRACT CHANGE ORDER NO. _____
SHEET _____ OF _____

BRIDGE STRUCTURES GIRDER EASTBOUND
SKYWAY STRUCTURES
SCALE: 1:200

E-808

THIS PLAN ACCURATE FOR ELECTRICAL WORK ONLY.

ALL DIMENSIONS ARE IN METERS UNLESS OTHERWISE SHOWN
FOR REDUCED PLANS ORIGINAL SCALE IS IN MILLIMETERS

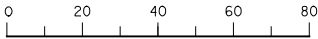

DGN FILE =>04-0120f1_E-808.dgn
USERNAME =>iloric

CU 04251

EA 0120F1

DIST COUNTY ROUTE KILOMETER POST TOTAL SHEET

04 SF,Ala 80 12.2/14.3 0.0/4.0 407a 1204

REGISTERED ELECTRICAL ENGINEER DATE

Syn Yee Chin 03/08/10

PLANS APPROVAL DATE

05-06-2010

PB AMERICAS, Inc.

A Parsons Brinckerhoff Company

303 Second St., Suite 700N

San Francisco, CA 94107-1317

REGISTERED PROFESSIONAL ENGINEER

SYN YEE CHIN

No. 18186

Exp. 09/30/2011

ELECTRICAL

STATE OF CALIFORNIA

The State of California or its officers or agents shall not be responsible for the accuracy or completeness of electronic copies of this plan sheet.

Caltrans now has a web site To get to the web site, go to http://www.dot.ca.gov

DATE PLOTTED => 25-MAY-2010
TIME PLOTTED => 11:19
LAST REVISION
00-00-00